


AREA EVALUATION

FIRST FLOOR	1464 SQ FT
SECOND FLOOR	2414 SQ FT
GAZONIA	200 SQ FT
COV ENTRY PORCH	400 SQ FT
SCREENED PORCH	400 SQ FT
TOTAL UNDER ROOF	3118 SQ FT

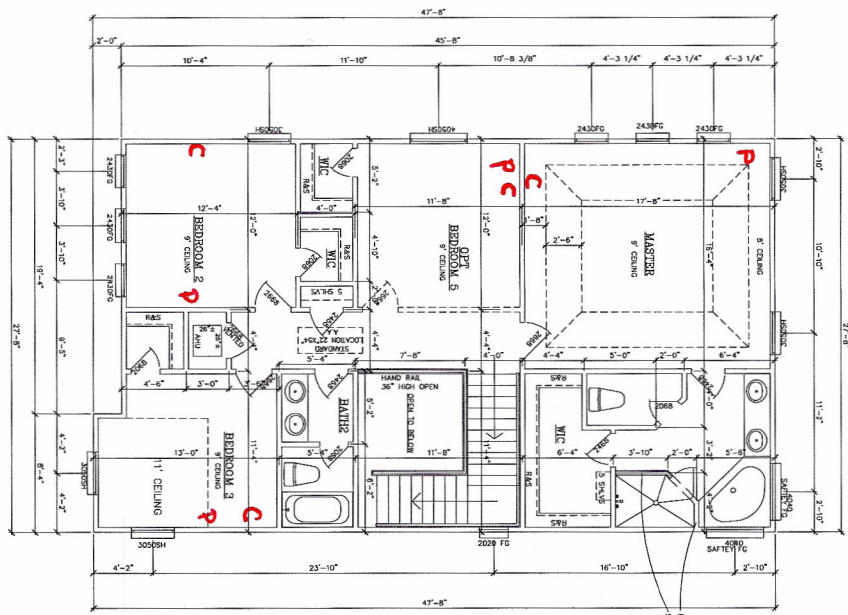

10'-1 1/8" PLATE
16" FLA TRUSS
3/4" SLIB FLR
TOTAL RISE
11'-5 7/8"
19 RISERS
7 1/4"±
18 TREADS
9 1/2"

A-1

DATE	10/20/09
SCALE	1/4" = 1'-0"
BY	JW/ML
CHECKED	ML
DATE	10/20/09
APP. CONTRACTOR	
APP. ARCHITECT	

A CUSTOM HOME FOR:
DREAMBUILDER 10
TO BE BUILT AT:
LOT 5 SANCTUARY

1800 MOURNING DOVE
LANE, JACKSONVILLE
BEACH, FLA.

PLAN
PLAN 2617

TRADE	VENDOR	M/D/Y	TRADE	VENDOR	M/D/Y	TRADE	VENDOR	M/D/Y	TRADE	VENDOR	M/D/Y	CONCRETE SQUARE FOOTAGES (±)		
STRUCT.			LANDSCAPE			SURVEYOR			DRIVEWAY:	905	ENTRY WALK:	98	STREET WALK:	XXXX